

LION'S CHOICE

440 N.W. CHIPMAN

RIGHT ELEVATION BUILDING:

$$23.00' \times 6.50' = 149.50'$$

$$17.25' \times 32.00' = 552.00'$$

$$19.00' \times 25.00' = 475.00'$$

$$1176.50' \times 10\% = 117.65 \text{ } \phi \text{ AVAILABLE}$$

RIGHT ELEVATION SIGNAGE:

" LION'S CHOICE "

$$52.00'' \times 168.00'' = 8736.00'' \div 144 = 60.67 \text{ } \phi$$

" LOGO "

$$96.00'' \times 75.00'' = 7200.00'' \div 144 = \underline{50.00 \text{ } \phi}$$

$$110.67 \text{ } \phi \text{ TOTAL}$$

SIGNAGE



1818 HWY. M  
BARNHART, MO 63012  
PH: 636-464-0200  
FAX: 636-464-9990  
WWW.PIROSSIGNS.COM  
GRAPHICS@PIROSSIGNS.COM

CUSTOMER  
Lions Choice

JOB LOCATION  
Lees Summit

CONTACT

SALES PERSON  
Mike M

DATE  
8/19/19

DRAWN BY  
Mike R

SAVED AS  
19-5021 Lees Summit Lions  
Choice

RENDERING #  
-01

REVISION(S)  
-02:  
  
-03:  
  
-04:  
  
-05:  
  
-06:  
  
-07:  
  
-08:  
  
-09:  
  
-10:

☐ APPROVED AS IS  
☐ APPROVED AS NOTED  
☐ REVISE & RESUBMIT

INITIALS \_\_\_\_\_

THIS PROOF IS APPROVED AS IS. NO WORK SHALL BEGIN UNTIL PIROS RECEIVES A SIGNED COPY. ANY CHANGES MAY RESULT IN A CHANGE IN THE PRICE QUOTED.

THIS DRAWING IS COPYRIGHT PROTECTED AND IS SOLE PROPERTY OF PIROS SIGNS INC. AND HAS BEEN PRE-PARED FOR YOUR VIEWING ONLY. THIS DRAWING MAY NOT BE REPRODUCED, DUPLICATED OR CONSTRUCTED WITHOUT WRITTEN PERMISSION OR PURCHASE FROM PIROS SIGNS INC.

FILE NUMBER E340574

ELECTRIC SIGN

THIS SIGN IS INTENDED TO BE INSTALLED IN ACCORDANCE WITH THE REQUIREMENTS OF ARTICLE 600 OF THE NATIONAL ELECTRIC CODE AND/OR OTHER APPLICABLE LOCAL CODES. THIS INCLUDES PROPER GROUNDING AND BONDING OF THE SIGN.



## Front Lit Channel Letters w/ Logo Cabinet

SCALE: 1/2" = 1'-0"

FABRICATE AND INSTALL (x3) SETS FRONT LIT CHANNEL LETTERS AND LOGO ON RACEWAYS.

- CHANNEL LETTERS**
- INDIVIDUALLY FABRICATED ALUMINUM LETTERS
  - RED PLASTIC FACES
  - LETTER RETURNS PAINTED MAP TO MATCH PMS 186 RED
  - LETTERS ILLUMINATED WITH RED LED
  - LETTERS MOUNTED ON TOP OF RACEWAY

- LOGO CABINET**
- CUSTOM SHAPED ALUMINUM CABINET
  - WHITE PLASTIC FACE
  - FACE DECORATED WITH OPAQUE BLACK VINYL
  - ILLUMINATED WITH WHITE LED
  - CABINET RETURN PAINTED BLACK
  - CABINET MOUNTED ON FACE OF RACEWAY


- 

PMS 186 RED  
ARLON 33 RED VINYL  
2793 RED ACRYLIC
- 

OPAQUE BLACK VINYL
- 

MAP BRUSHED ALUMINUM

# Channel Letter Install Guide

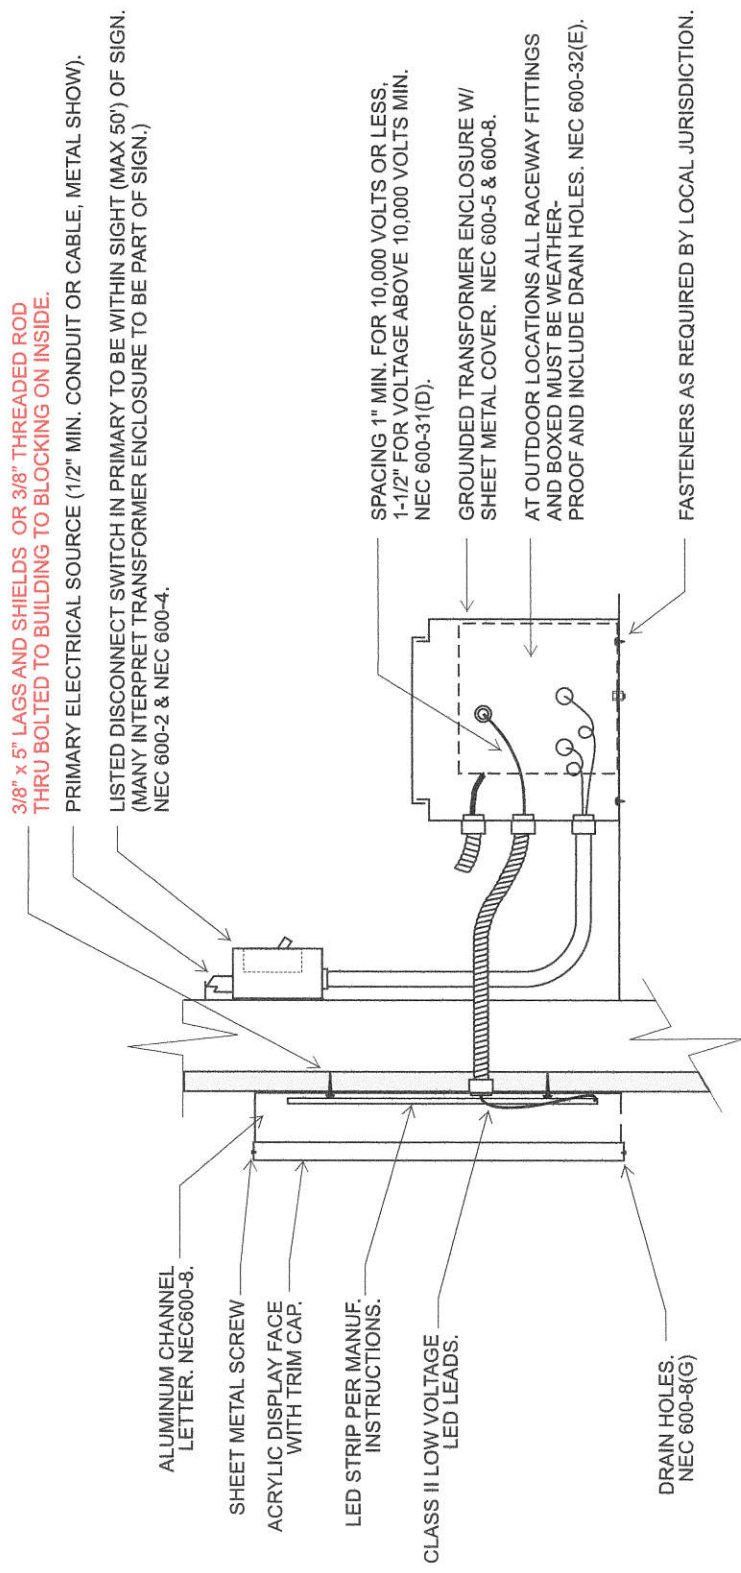



1818 HWY. M  
BARNHART, MO 63012  
PH: 636-464-0200  
FAX: 636-464-9990  
WWW.PIROSSIGNS.COM  
GRAPHICS@PIROSSIGNS.COM

**CUSTOMER**  
Lions Choice

**JOB LOCATION**  
Lees Summit

**CONTACT**

**SALES PERSON**  
Mike M

**DATE**  
8/19/19

**DRAWN BY**  
Mike R

**SHEET AS**  
19-5021 Lees Summit Lions Choice

**REVISIONS**

- 02
- 02: Changed B1 to black illuminated lion
- 03:
- 04:
- 05:
- 06:
- 07:
- 08:
- 09:
- 10:

☐ APPROVED AS IS  
☐ APPROVED AS NOTED  
☐ REVISE & RESUBMIT

INITIALS

THIS SIGN IS INTENDED TO BE INSTALLED IN THE MIDDLE OF THE BUILDING. IT IS NOT TO BE PLACED IN THE CORNER. A SIGNPOST, NOT SHOWN HERE, WILL BE USED TO HOLD THE SIGN IN PLACE.

THIS DRAWING IS COPYRIGHT PROTECTED AND IS THE PROPERTY OF PIRO SIGNS INC. AND THIS DRAWING IS NOT TO BE REPRODUCED OR COPIED IN ANY MANNER WITHOUT THE WRITTEN PERMISSION OF PIRO SIGNS INC.

**PIROSSIGNS** **ELECTRIC SIGN**

THIS SIGN IS INTENDED TO BE INSTALLED IN THE MIDDLE OF THE BUILDING. IT IS NOT TO BE PLACED IN THE CORNER. A SIGNPOST, NOT SHOWN HERE, WILL BE USED TO HOLD THE SIGN IN PLACE.

## Halo Illuminated Wall / Stack Sign

- SCALE: 3/4" = 1'-0"
- PRODUCE & INSTALL 1 WALL SIGN TO GO ON BUILDING CORNER (2 ELEVATIONS).
- CONTOUR CUT PERFORATED ALUMINUM PANEL PAINTED WHITE
  - ROUTED 3/8" CLEAR ACRYLIC LION DETAILS PAINTED BLACK
  - ACRYLIC MOUNTED TO PERFORATED ALUMINUM WITH STUDS
  - SIGN TO STAND OFF SURFACE 1-1/2" - 2"
  - MOUNTING METHOD TBD
  - ILLUMINATED WITH WHITE LED


BLACK



WALL MATERIALS AND COLOR TBD



# Channel Letter Install Guide

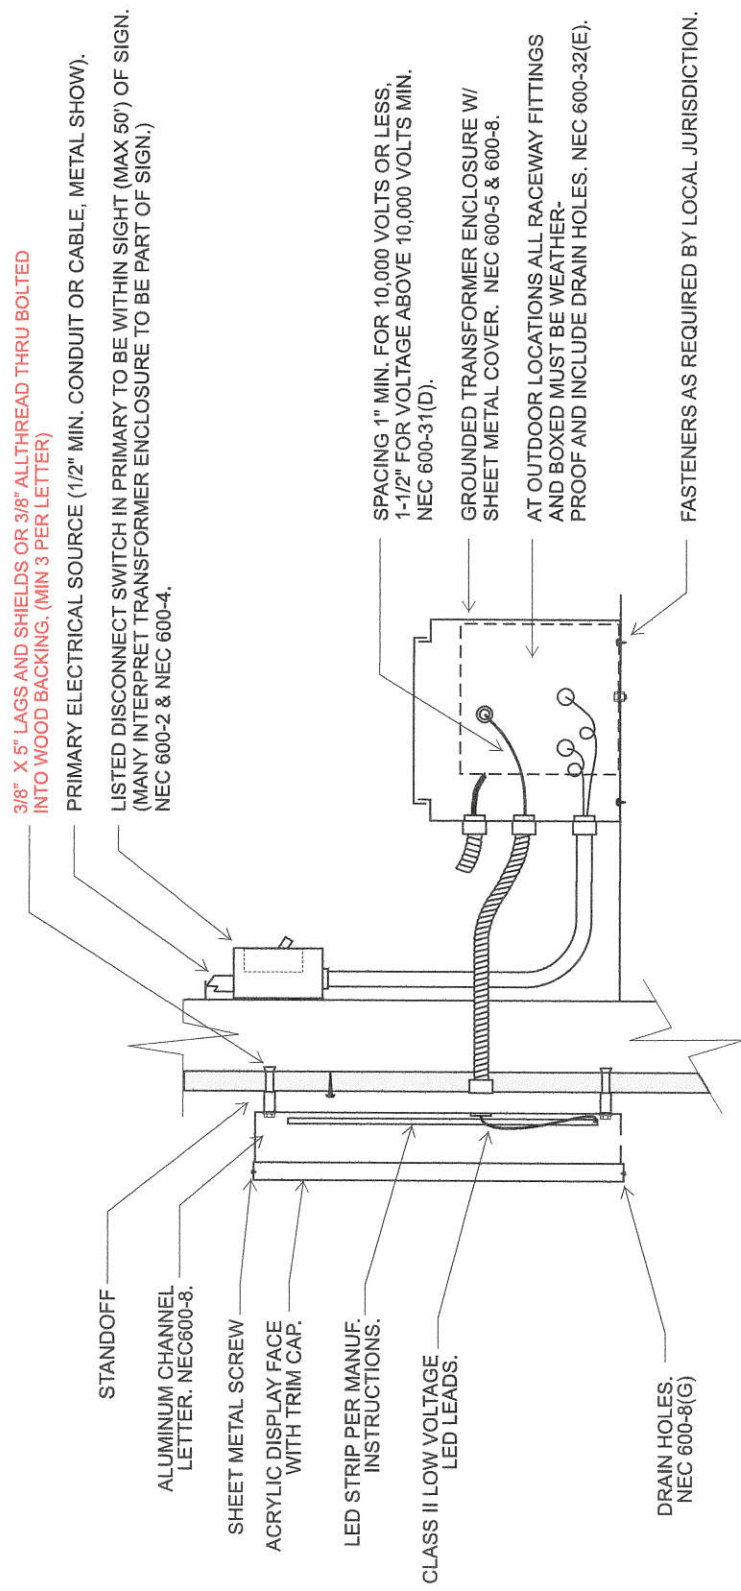





1818 HWY. M  
BARNHART, MO 63012  
PH: 636-464-0200  
FAX: 636-464-9990  
WWW.PIROSSIGNS.COM  
GRAPHICS@PIROSSIGNS.COM

CUSTOMER  
Lions Choice

JOB LOCATION  
Lees Summit

CONTACT

SALES PERSON  
Mike M  
DATE  
8/19/19  
DRAWN BY  
Mike R  
SAVED AS  
19-5021 Lees Summit Lions  
Choice

RENDERING #

-01

REVISION(S)

-02:

-03:

-04:

-05:

-06:

-07:

-08:

-09:

-10:

☐ APPROVED AS IS  
☐ APPROVED AS NOTED  
☐ REVISE & RESUBMIT

INITIALS

THIS PROOF IS APPROVED AS IS. NO WORK SHALL BEGIN UNTIL PIROSSIGNS RECEIVES A SIGNED COPY. ANY CHANGES MAY RESULT IN A CHANGE IN THE PRICE QUOTED.

THIS DRAWING IS COPYRIGHT PROTECTED AND IS SOLE PROPERTY OF PIROSSIGNS INC. AND HAS BEEN PRE-PARED FOR YOUR VIEWING ONLY. THIS DRAWING MAY NOT BE REPRODUCED, DUPLICATED OR CONSTRUCTED WITHOUT WRITTEN PERMISSION OR PURCHASE FROM PIROSSIGNS INC.



THIS SIGN IS INTENDED TO BE INSTALLED IN ACCORDANCE WITH THE REQUIREMENTS OF ARTICLE 600 OF THE NATIONAL ELECTRIC CODE AND/OR OTHER APPLICABLE LOCAL CODES. THIS INCLUDES PROPER GROUNDING AND BONDING OF THE SIGN.

