
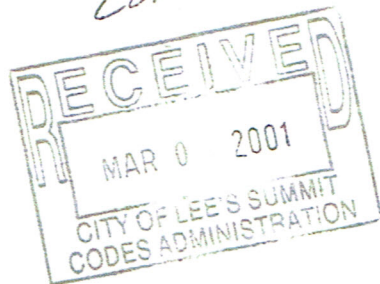


...shall be provided to the owner of the property...
 ...shall be provided to the owner of the property...
 ...shall be provided to the owner of the property...

APPROVED [Signature] DATE 3-5-01
 PLATTED Tom Scamell

No Sidewalk req.
 Variance for front rear
 setbacks granted
 by BZA on
 10-25-00.

Proposed uncovered
 deck.

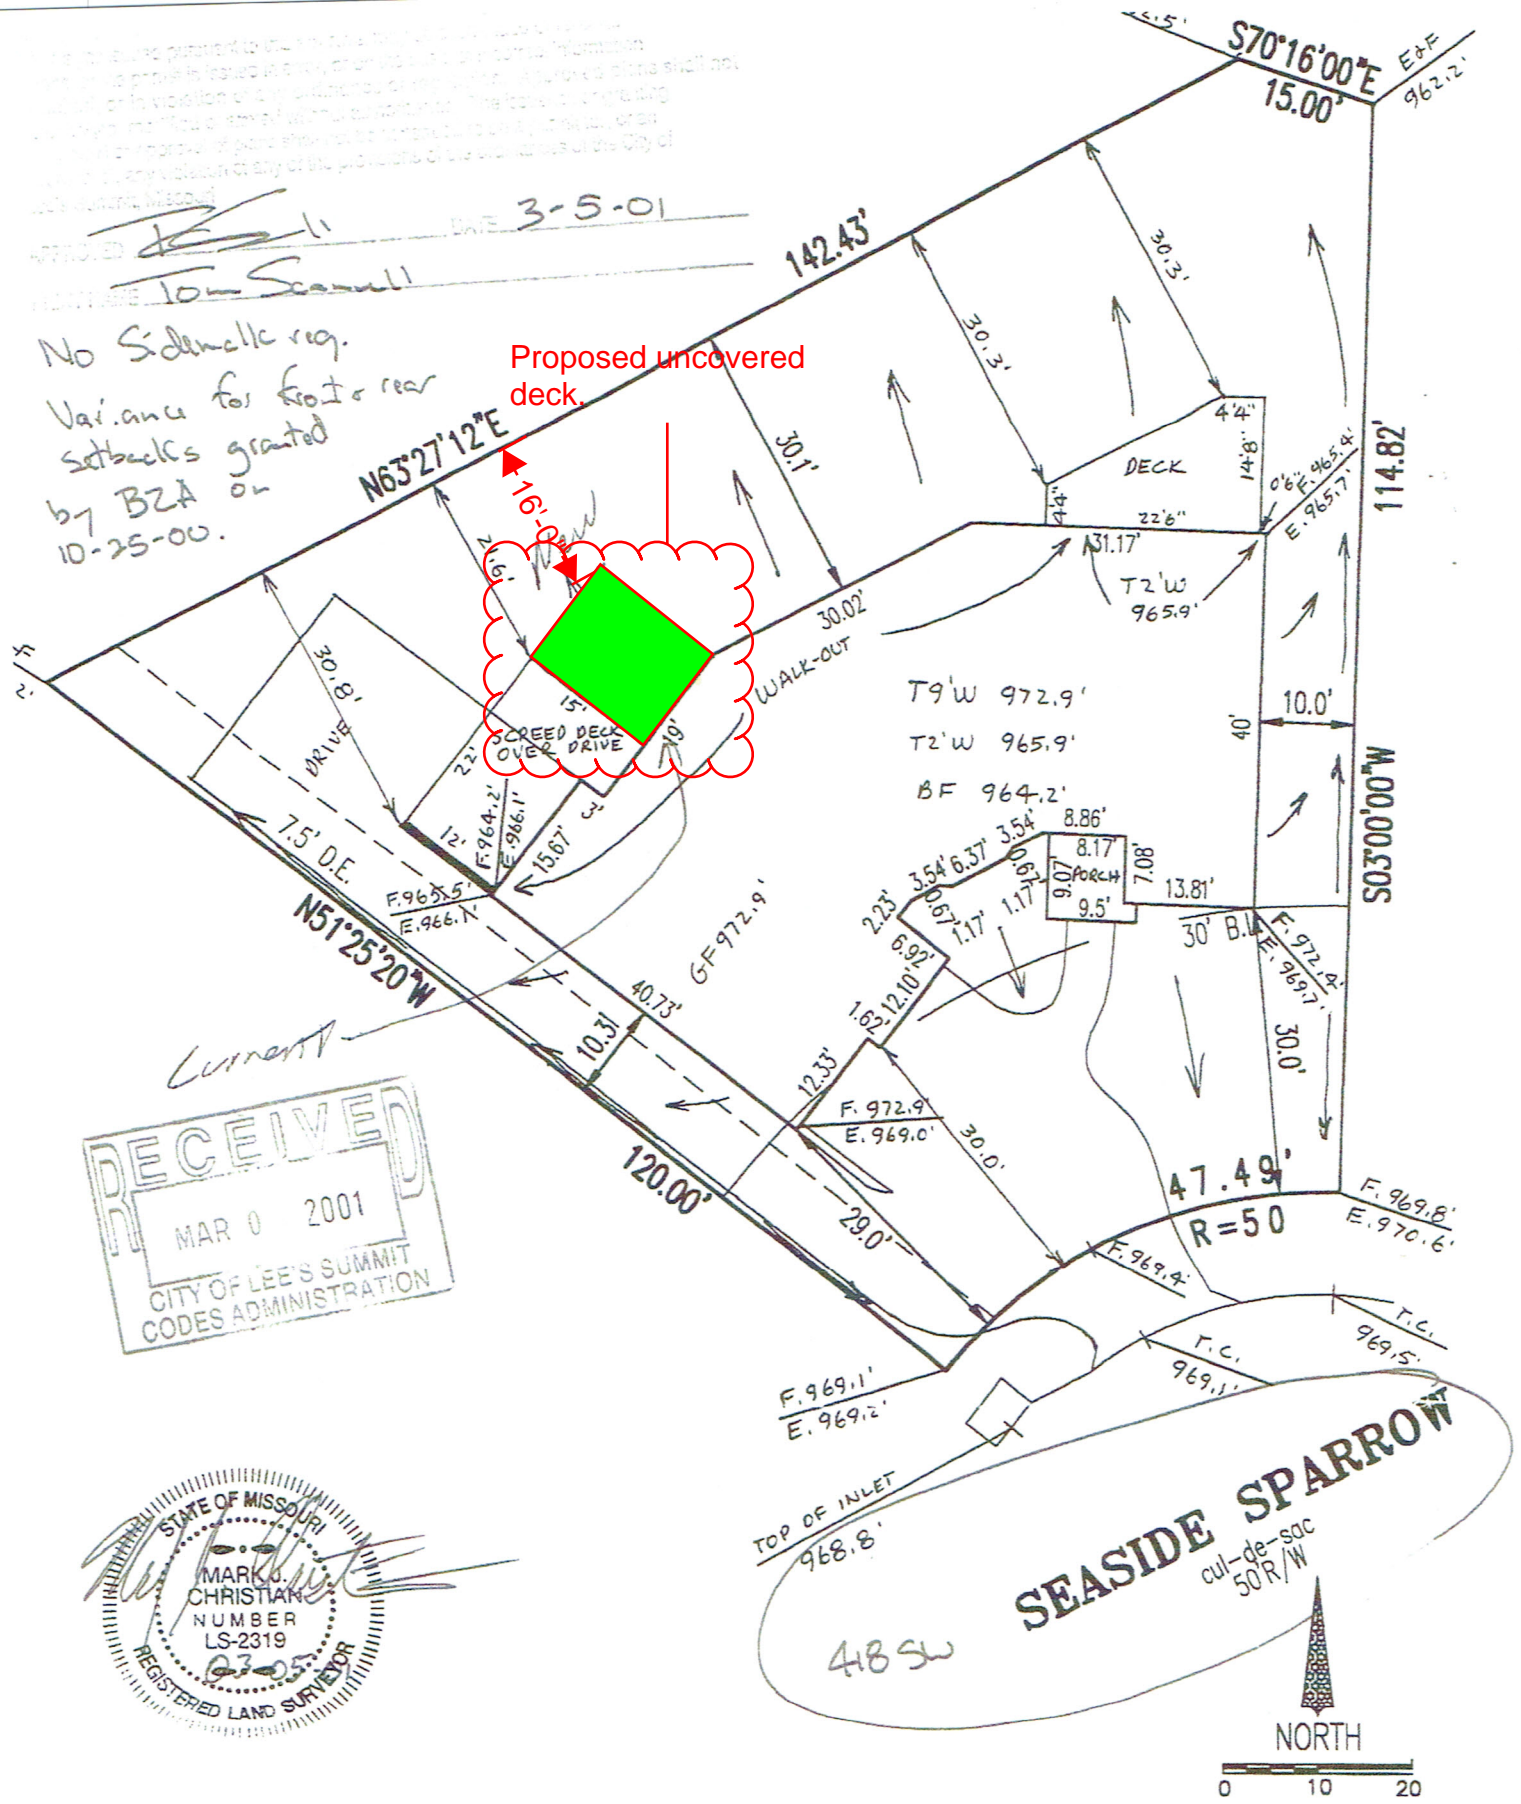

ATTENTION: Contractor to check and verify house dimensions and elevations at job site. We are not responsible for unknown or unplatted easements of any kind unless we are furnished the description of said easements before the field work is performed. NOTE: Final decision as to cuts and foundation height are to be made by builder on job site. NOTE: This plot plan is not to be construed as a boundary survey, and is not to be used for construction of fences. This plot plan is not an "AS-BUILT SURVEY" as the house shown was staked prior to construction and cannot be used in place of a "SURVEYOR'S REAL PROPERTY REPORT" or "MORTGAGE INSPECTION". © Copyright 2001

SCALE: 1" = 20'
 DATE: 03-05-01
 JOB NO: 01078